


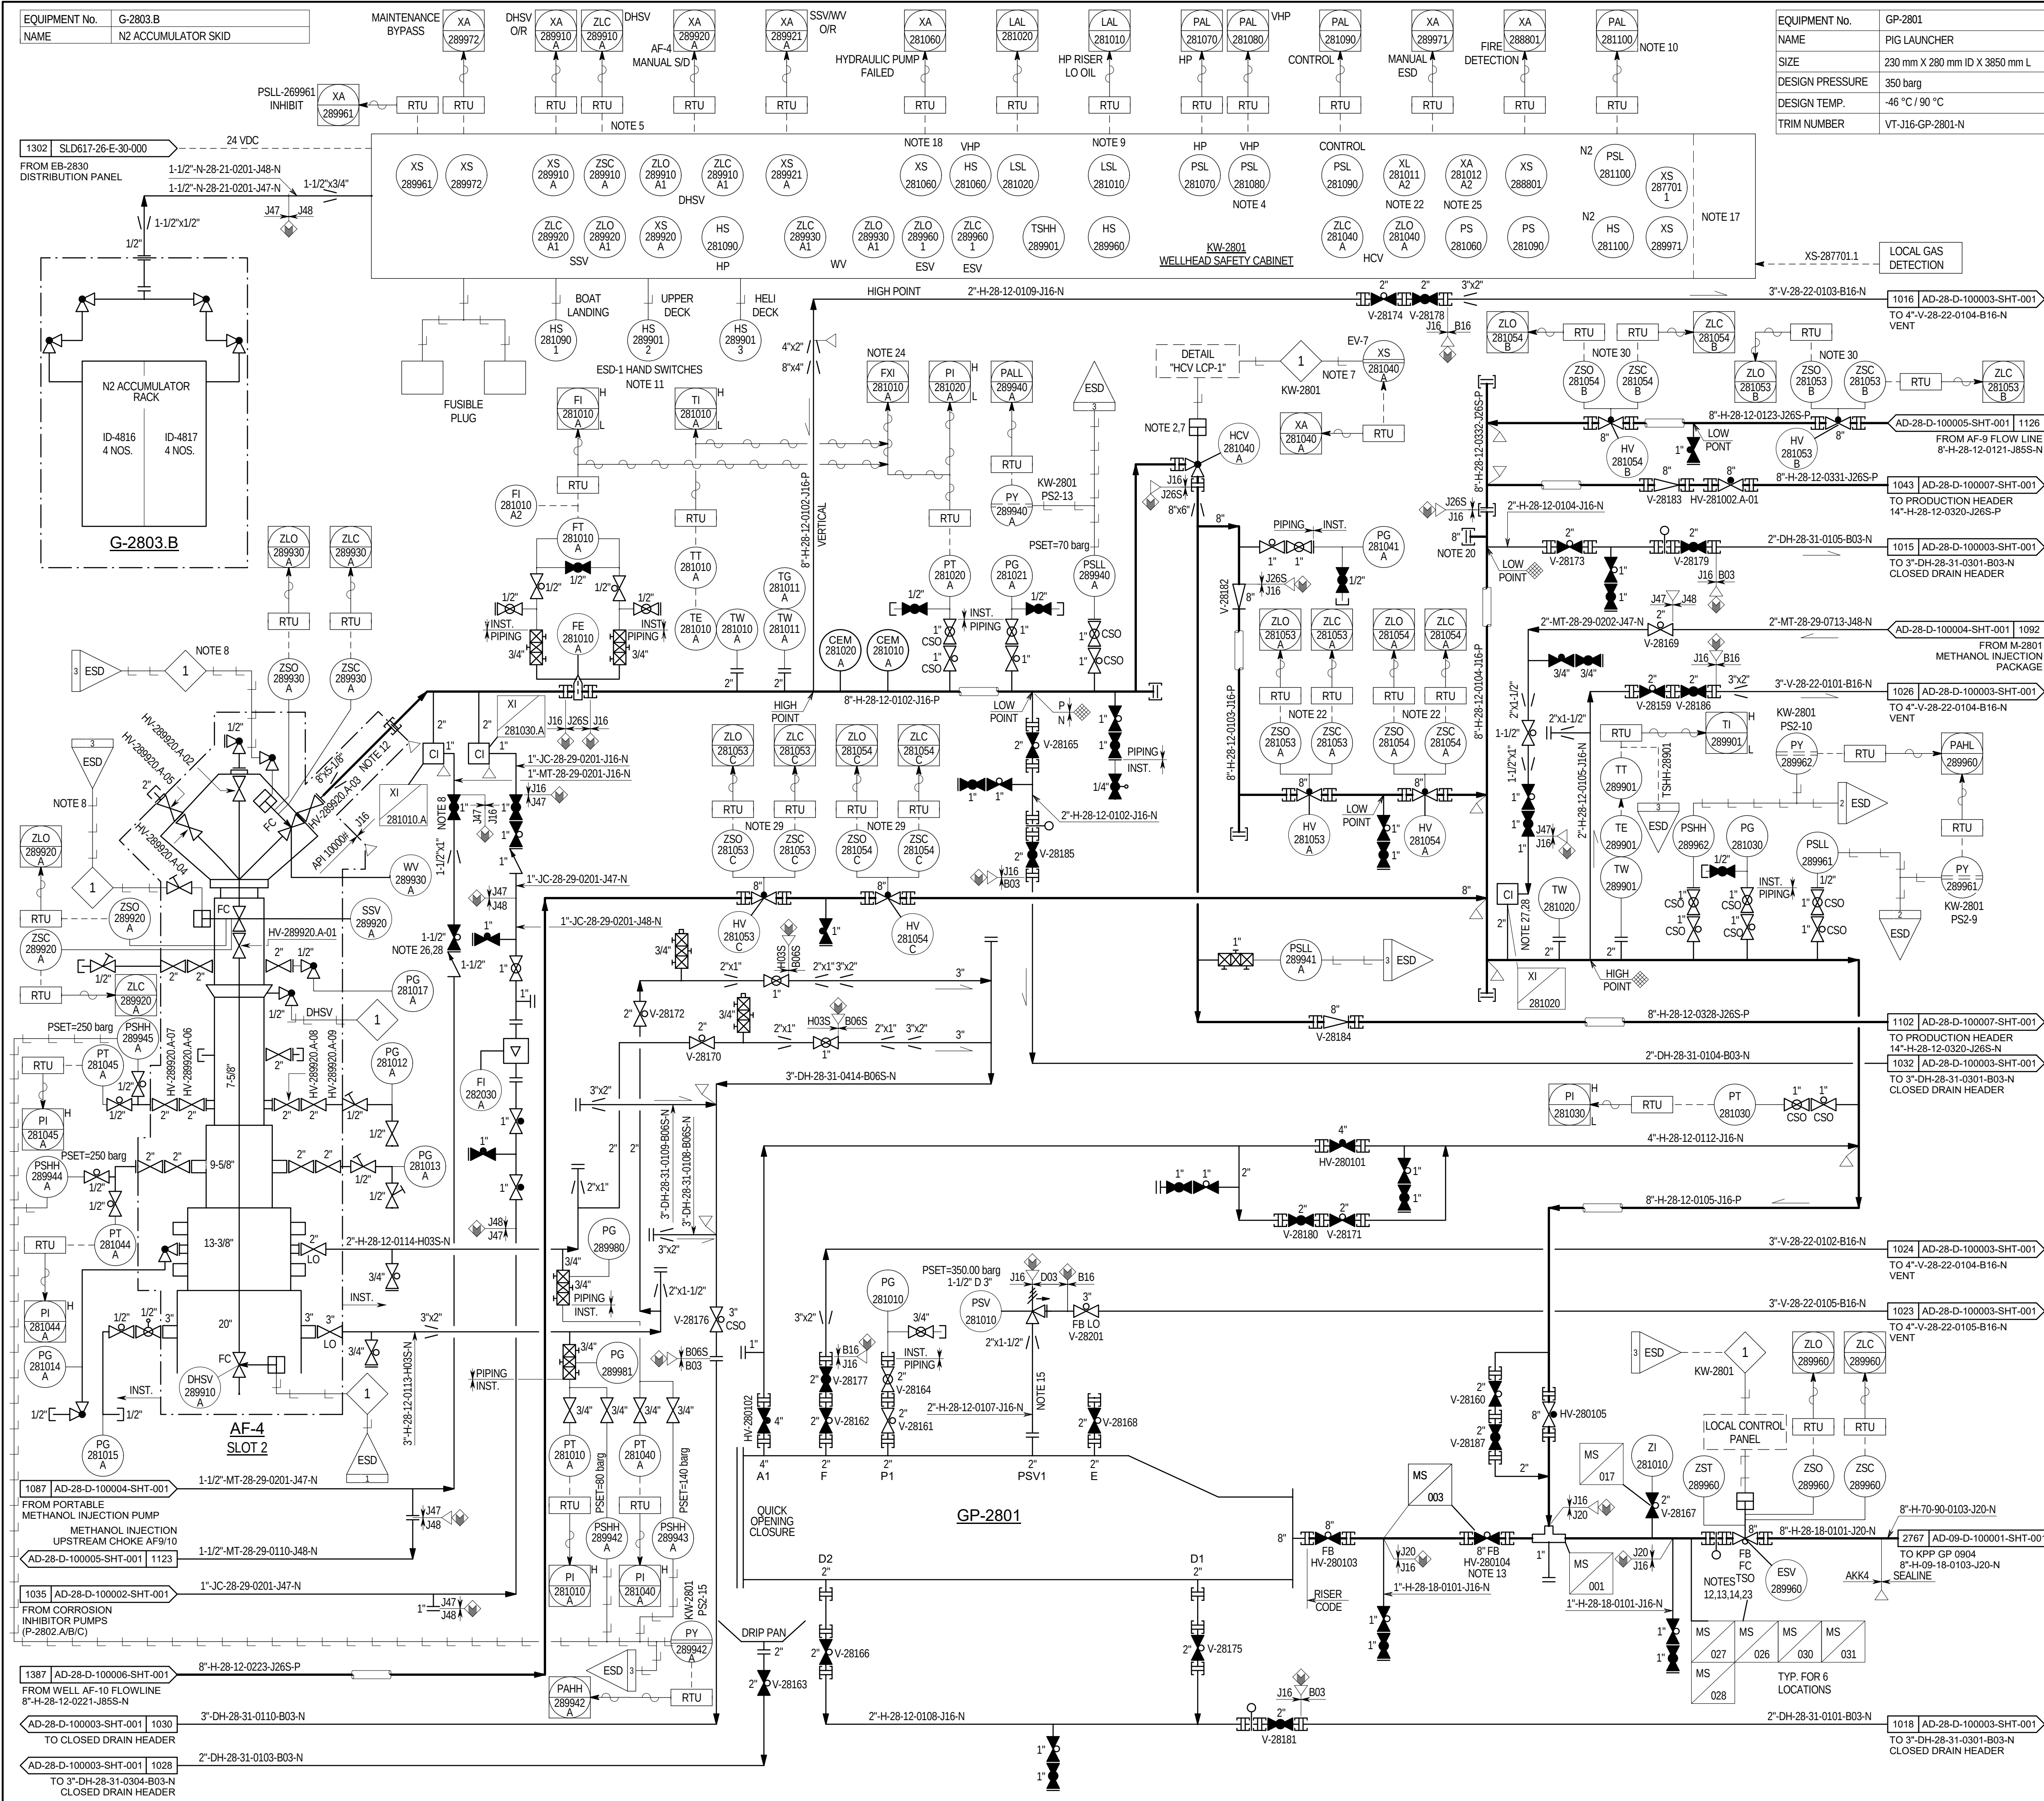

- NOTES
1.

LOW LOW OR HIGH HIGH PRESSURE CLOSE WING AND MASTER VALVES OF TEST WELL FLOWING TO KPP AND ESV 289960.
2.

INCASE OF SHUTDOWN, CHOKE VALVE ARE AUTOMATICALLY CLOSE.
3.

ANNULLUS PRESSURE THROUGH PRODUCTION CASING.
4.

PRESSURE INDICATOR FOR HYDRAULIC NETWORK.
5.

POSITION STATUS OF DOWNHOLE SAFETY VALVE.
6.

CLOSE WING AND MASTER IN SEQUENCE.
7.

PERMISSION TO OPEN THE WELLHEAD VALVES ONLY WHEN CHOKE IS CLOSED.
8.

QUICK DUMP VALVES INSTALLED TO REDUCE CLOSURE TIME OF MASTER AND WING VALVE INCLUDING WELLHEAD PANEL.
9.

HYDRAULIC OIL RESERVOIR LEVEL FOR SAFETY CABINET.
10.

PRESSURE FOR NITROGEN BACK-UP.
11.

HYDRAULIC LOCAL SWITCHES AT BOAT LANDING, UPPER DECK AND HELIDECK TO CLOSE DSV, MV, WV, ESV AND CHOKE VALVE IN EMERGENCY CASE.
12.

SPOOL PIECE FOR MAINTENANCE PURPOSES.
13.

INSIDE DIAMETER OF BALL VALVES IDENTICAL TO INSIDE DIAMETER OF PIPELINE.
14.

ESV ON RISER TO BE LOCATED IN SAFE AREA AWAY FROM POTENTIAL FIRE OR EXPLOSION SOURCES. HOWEVER, ACCESS AND MAINTENANCE FACILITIES TO BE PROVIDED.
15.

METHANOL AND NITROGEN SUPPLY POINTS TO BE CLOSE TO PIG TRAP, (MAINTENANCE AFTER PIGGING OPERATION)
16.

FI LOCALLY READABLE FROM CHOKE VALVE.
17.

WELLHEAD SAFETY CABINET TO BE DESIGNED FOR TWO WELLS AND ONE IN FUTURE.
18.

PUMP FAIL ALARM.
19.

IDENTICAL ARRANGEMENT TO K2 WELLHEAD.
20.

CONNECTIONS FOR FUTURE WELLHEADS.
21.

LOW LOW PRESSURE CLOSE WING AND MASTER VALVES.
22.

POSITION INDICATORS ON WHCP (XL-281011.A2) & DCS (XL-281011.A) INDICATE WHICH WELL IS ON TEST.
23.

PARTIAL STROKING FACILITIES ADDED.
24.

CORRECTED GAS FLOW CALCULATED IN PLC.
25.

SIMULTANEOUS OPENING (WITH TIME DELAY) / CLOSURE (WITH WELL ON) OF PRODUCTION / TEST LINES ARE ALARMED ON DCS (XA-281012.A) / WHCP (XA-28012.A2).
26.

INJECTION POINT TO BE CLOSE TO WING VALVE.
27.

METHANOL INJECTION DEPENDANT ON WELLSTREAM TEMPARATURE AND PRESSURE.
28.

SHUT-IN VALVE (TYPE GLOBE) PART OF CAPROCO.
29.

POSITION INDICATORS ON WHCP (XL-281011.C2) & DCS (XL-281011.C) INDICATE WHICH WELL IS ON TEST.
30.

POSITION INDICATORS ON WHCP (XL-281011.B2) & DCS (XL-281011.B) INDICATE WHICH WELL IS ON TEST.

- LOGIC NOTES
- 1

TOIFROM WELLHEAD SAFETY CABINET.

REFERENCE DRAWINGS	
DESCRIPTION	DRAWING NUMBER
P&ID LEGEND, SYMBOLS & INSTRUMENT DETAILS	AD-82-D-100001 TO AD-82-D-100005
INSTRUMENT CONNECTIONS STANDARD	SP.6714Y.00.1311.003

SITE WALKTHROUGH DONE ON 15 JAN 2024

THIS DRAWING SUPERSEDES TOTAL ABK DWG. NO. 0000617-28-U-99-101 1/1 REV-14

1	18 Jun 2025	AS-BUILT FOR PROJECT NO. 11594 (PACKAGE 6)	AA	MC	TK	GB	SB		
REV.	DATE	DESCRIPTION	BY	CHK	SD	APPD	APPD		
CONSULTANT/CONTRACTOR/VENDOR: AVENIR INT'L ENGINEERS & CONSULTANTS P.O. Box. 113917 Abu Dhabi, U.A.E									
DRAWING No. :									
PROJECT TITLE: 11594: AS-BUILT RECOVERY - PHASE II (PACKAGE 5: LZ - ZCSC & PACKAGE 6: ABK)									
ADNOC أدنوك البحرية ADNOC Offshore									
DRAWING TITLE: ABU AL BUKHOOSH WELL HEAD TOWER - AREA 28 AKK 4 WELL HEAD PLATFORM PRODUCTION LINES PIPING AND INSTRUMENTATION DIAGRAM									
BUDGET REF. 11594		DRAWING No.		REV.					
PROJECT No. 11594		SCALE N.T.S		AD-28-D-100001-SHT-001		1			