


EQUIPMENT No.	G-2802
NAME	CORROSION INHIBITOR PACKAGE
SIZE	1.85 m L X 1.3 m W X 2.25m H

EQUIPMENT No.	Q-2802
NAME	CORROSION INHIBITOR STORAGE TANK
SIZE	1000 mm OD X 4595 mm TL/TL
CAPACITY	3 m3/hr
DESIGN PRESS.	3.5 barg
DESIGN TEMP.	55 °C
TRIM NUMBER	VT-B56-Q-2802-N

EQUIPMENT No.	P-2802.A / B / C
NAME	CORROSION INHIBITOR INJECTION PUMPS
DESIGN FLOW RATE	6.3 l/hr
DESIGN DISCHARGE PRESS.	350 barg
DISCHARGE PRESS.	97 barg/276.0 barg
ESTIMATED POWER	0.3 kW

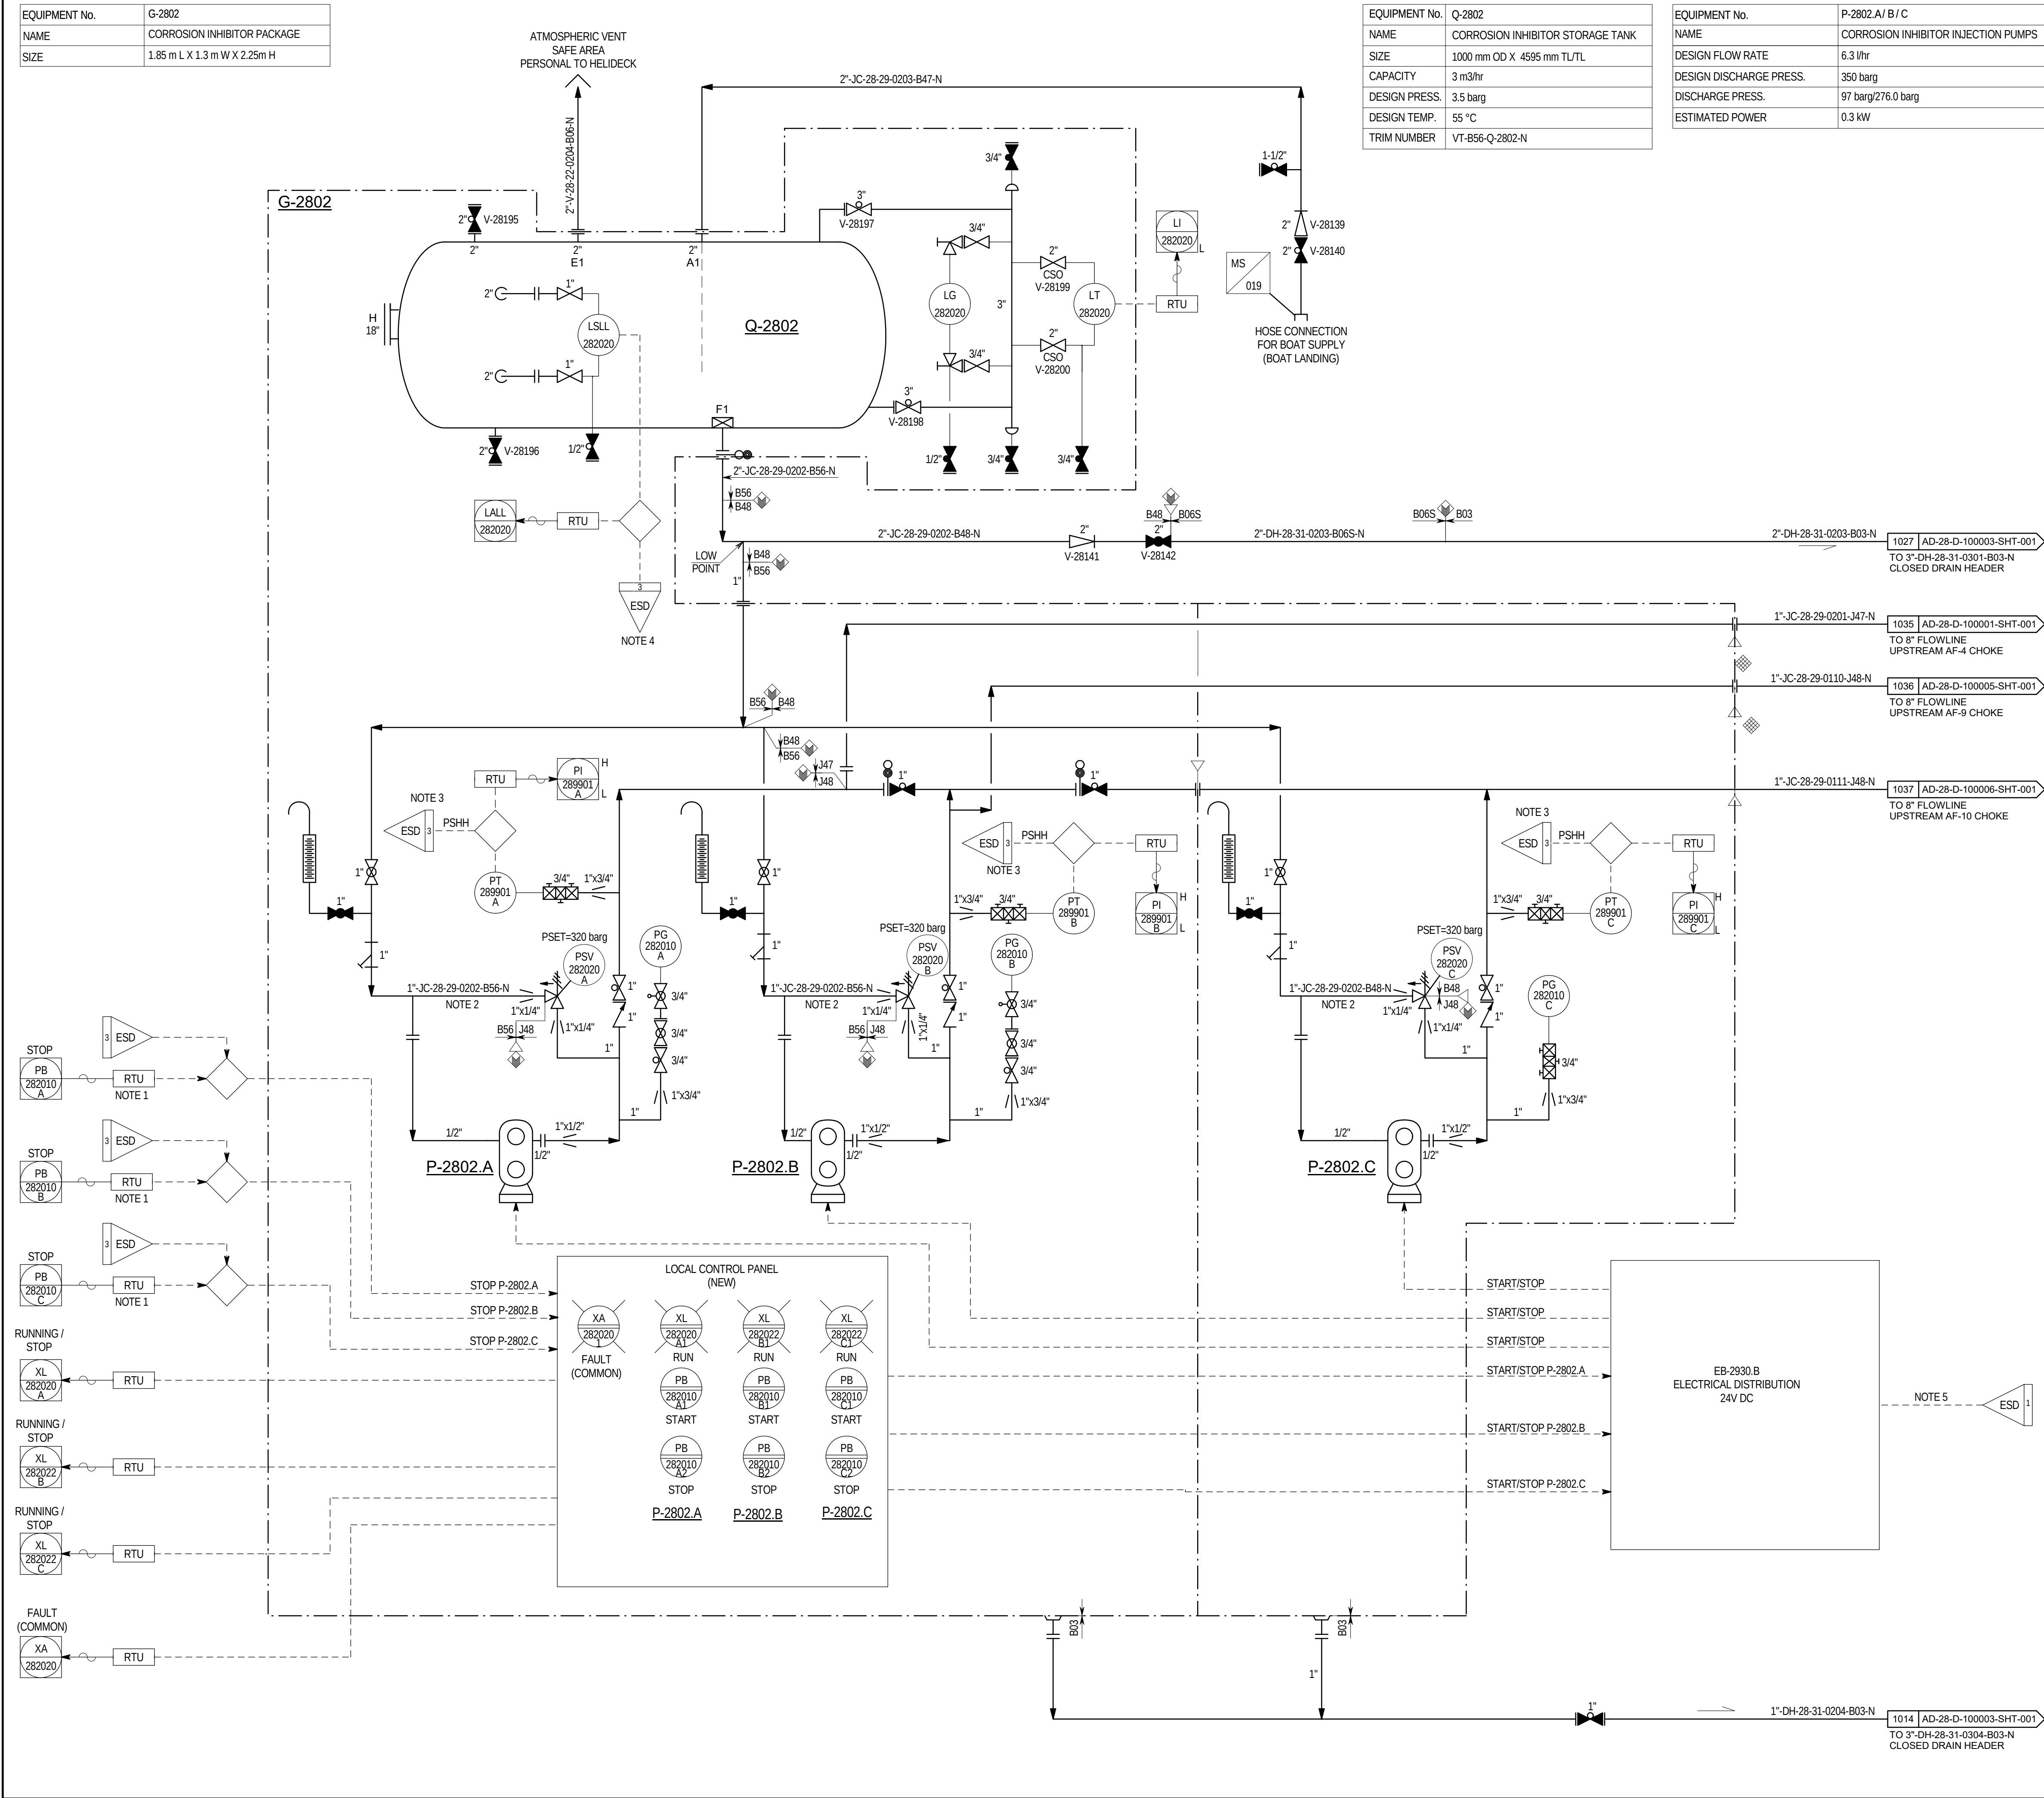

NOTES

- PB-282010 AND ESD 1-2 USE THE SAME R.T.U PHYSICAL OUTPUT.
- PSV AT DISCHARGE P-2802.A/B TO BE INSTALLED INCLUDE BY PACKAGE VENDOR.
- PSHH-289901.A STOP P-2802.A.
PSHH-289901.B STOP P-2802.B.
PSHH-289901.C STOP P-2802.C.
- LSLL-282020 STOPS ALL PUMPS P-2802.A, P-2802.B, P-2802.C.
- XS-289930 IS ESD-1 TRIP SIGNAL FOR PUMP P-2802.A, P-2802.B, P-2802.C.

REFERENCE DRAWINGS

DESCRIPTION	DRAWING NUMBER
P&ID LEGEND, SYMBOLS & INSTRUMENT DETAILS	AD-82-D-100001 TO AD-82-D-100005
INSTRUMENT CONNECTIONS STANDARD	SP.6714Y.00.1311.003

SITE WALKTHROUGH DONE ON 15 JAN 2024

THIS DRAWING SUPERSEDES TOTAL ABK
DWG. NO. 0000617-28-U-99-102 1/1 REV-10

REV.	DATE	DESCRIPTION	BY	CHK	SD	APPD	APPD
1	18 Jun 2025	AS-BUILT FOR PROJECT NO. 11594 (PACKAGE 6)	AA	MC	TK	GB	SB

CONSULTANT/CONTRACTOR/VENDOR:	AVENIR INT'L ENGINEERS & CONSULTANTS P.O. Box. 113917 Abu Dhabi, U.A.E
DRAWING No. :	

PROJECT TITLE: 11594: AS-BUILT RECOVERY - PHASE II
(PACKAGE 5: LZ - ZCSC & PACKAGE 6: ABK)



أدنوك البحرية
ADNOC Offshore

DRAWING TITLE:
ABU AL BUKHOOSH WELL HEAD TOWER - AREA 28
AKK 4 WELL HEAD PLATFORM
CORROSION INHIBITOR PACKAGE G-2802
PIPING AND INSTRUMENTATION DIAGRAM

BUDGET REF. 11594	DRAWING No. AD-28-D-100002-SHT-001	REV. 1
PROJECT No. 11594	SCALE N.T.S	