


EQUIPMENT No.	Q-2801
NAME	METHANOL INJECTION STORAGE TANK
SIZE	2000 mm ID X 6000 mm TL/TL
CAPACITY	m3/hr
DESIGN PRESS.	3.5 barg
DESIGN TEMP.	55 °C
TRIM NUMBER	VT-B02-Q-2801-N

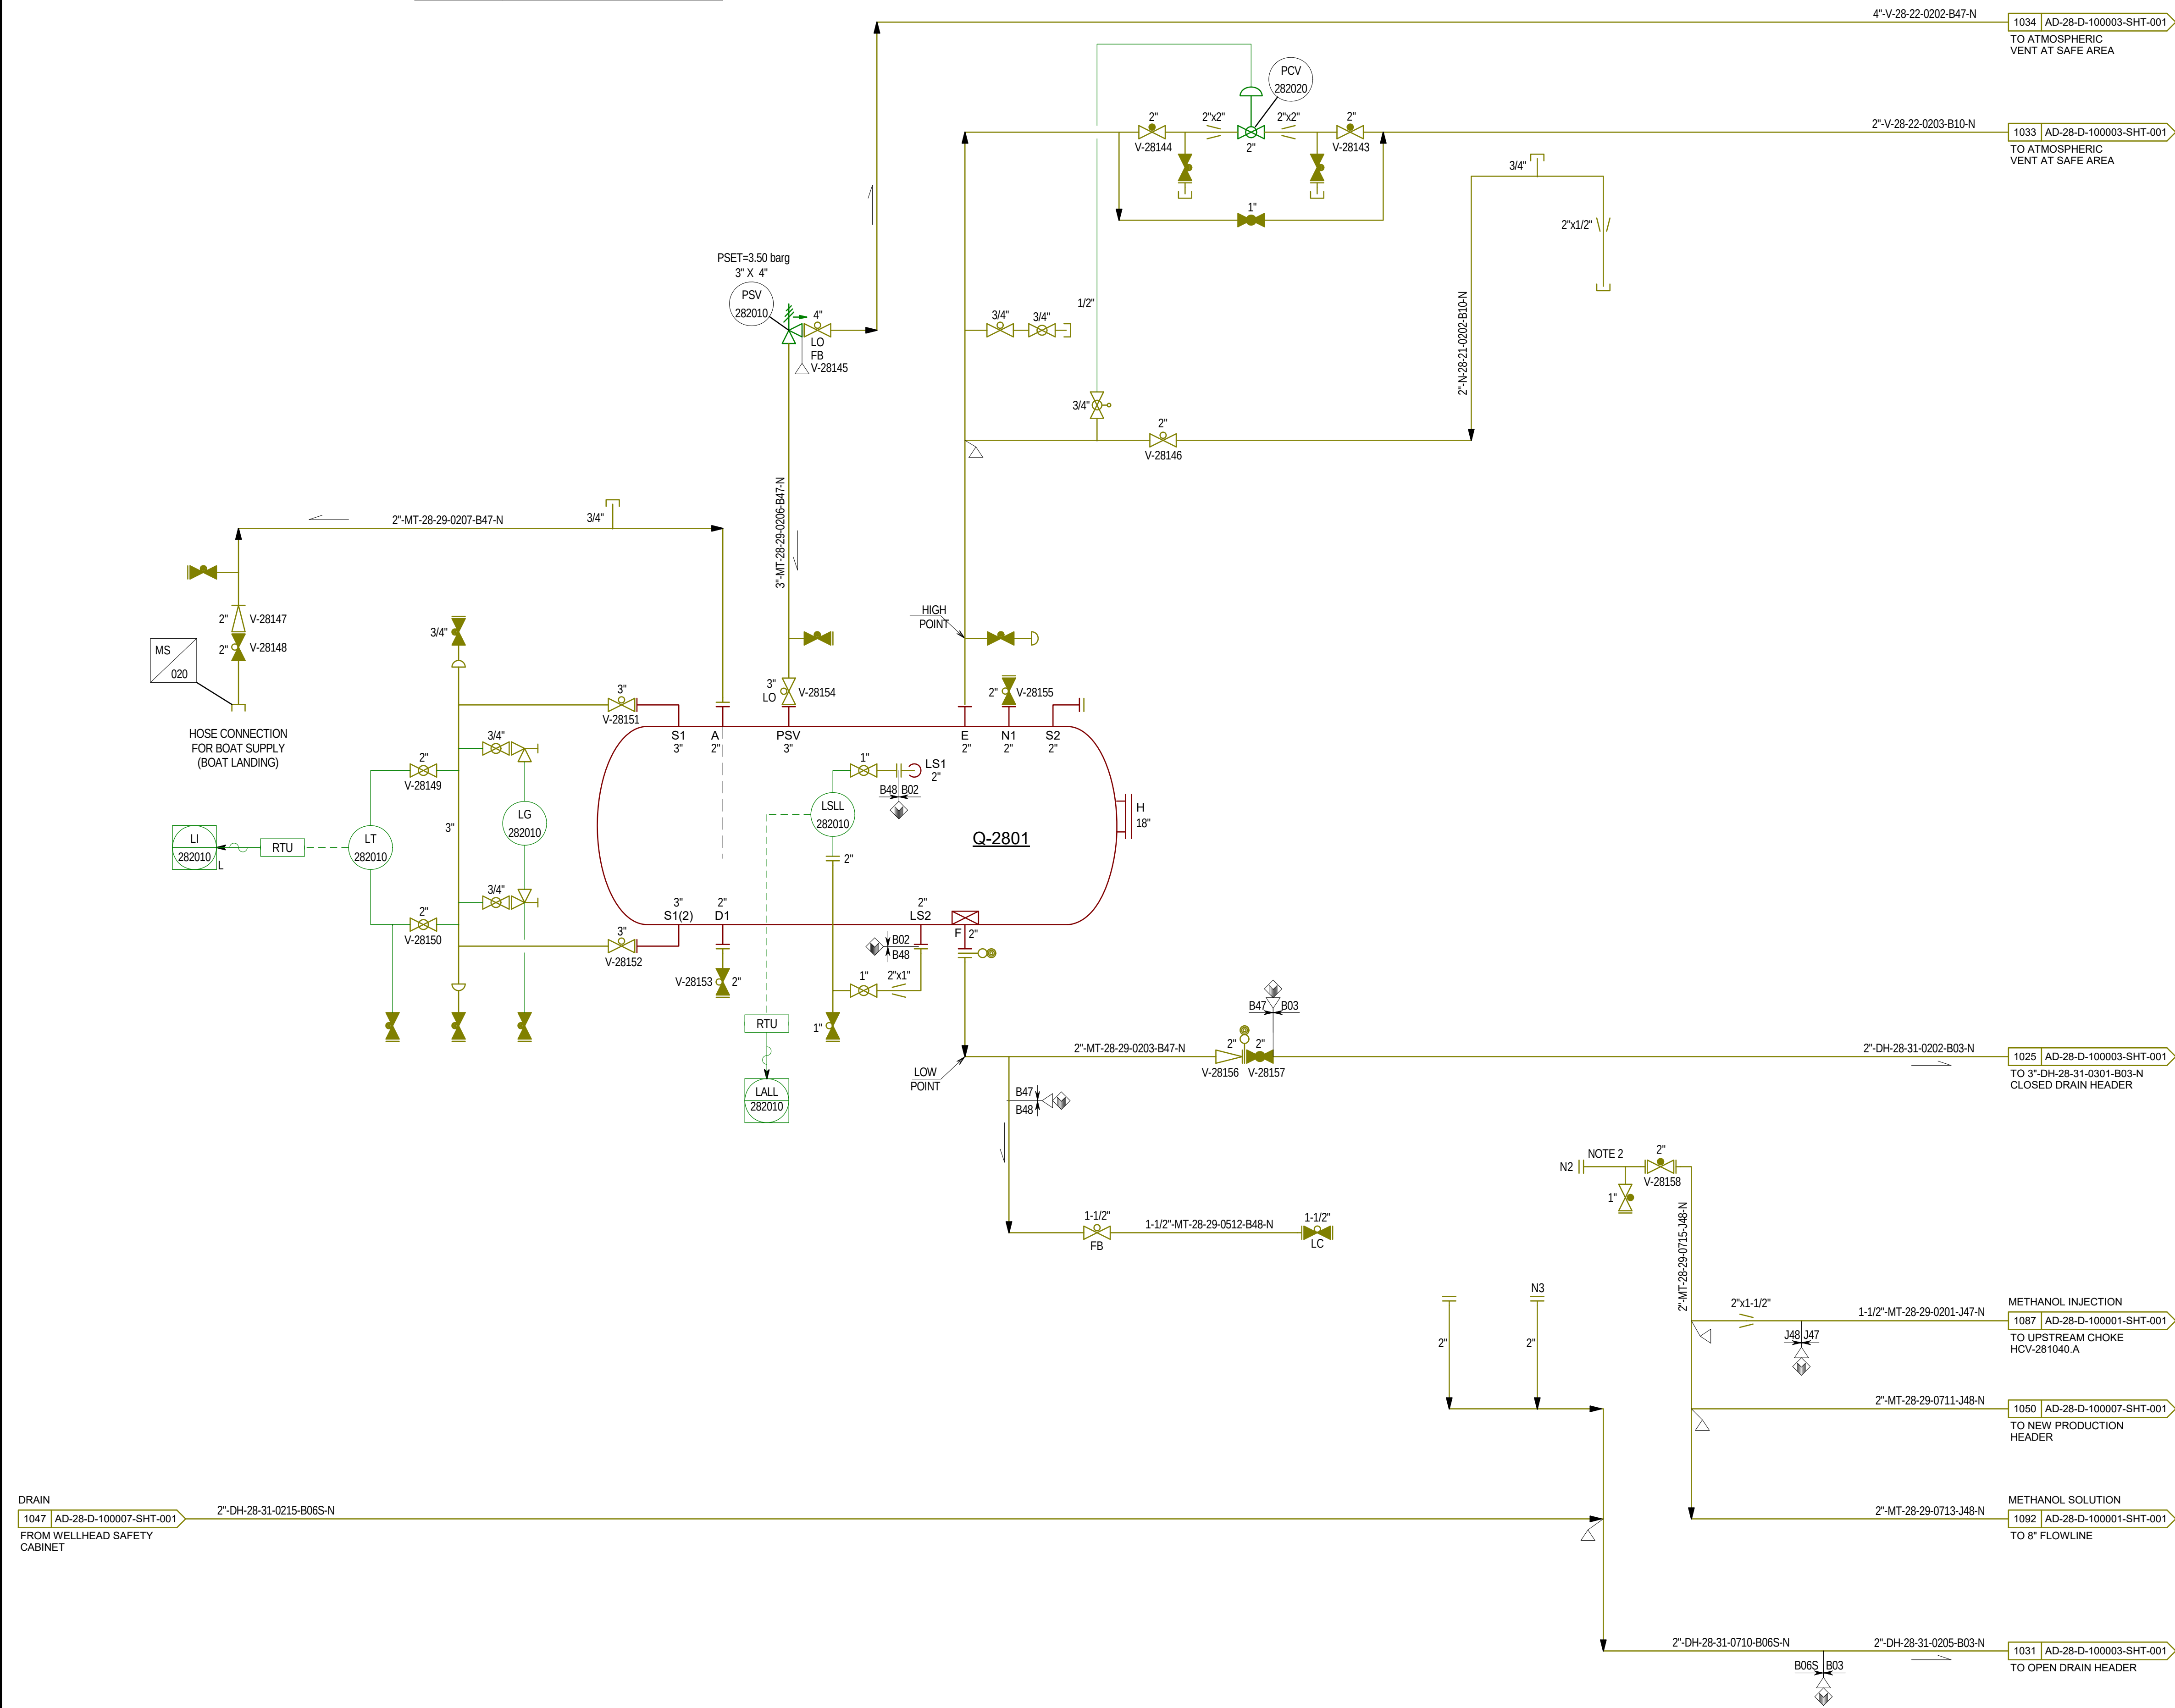

NOTES

- G-8201 IS PORTABLE SKID TO BE LOCATED AS PER OPERATIONAL REQUIREMENT. REFER P&ID NO. AD-82-D-100029-SHT-001 FOR DETAILS OF PORTABLE METHANOL INJECTION PACKAGE.
- LINE TO BE BLINDED WHEN SKID IS REMOVED.
- G-8201 IS NOT AVAILABLE DURING SITE WALKTHROUGH.

REFERENCE DRAWINGS

DESCRIPTION	DRAWING NUMBER
P&ID LEGEND, SYMBOLS & INSTRUMENT DETAILS	AD-82-D-100001 TO AD-82-D-100005
INSTRUMENT CONNECTIONS STANDARD	SP.6714Y.00.1311.003

SITE WALKTHROUGH DONE ON 15 JAN 2024

THIS DRAWING SUPERSEDES TOTAL ABK
DWG. NO. 0000617-28-U-99-105 1/1 REV-8

REV.	DATE	DESCRIPTION	BY	CHK	SD	APPD	APPD
1	18 Jun 2025	AS-BUILT FOR PROJECT NO. 11594 (PACKAGE 6)	AA	MC	TK	GB	SB

CONSULTANT/CONTRACTOR/VENDOR:		 INT'L ENGINEERS & CONSULTANTS		P.O. Box. 113917 Abu Dhabi, U.A.E	
DRAWING No. :					

PROJECT TITLE: 11594: AS-BUILT RECOVERY - PHASE II
(PACKAGE 5: LZ - ZCSC & PACKAGE 6: ABK)



أدنوك البحرية
ADNOC Offshore

DRAWING TITLE:
ABU AL BUKHOOSH WELL HEAD TOWER - AREA 28
AKK 4 WELL HEAD PLATFORM
METHANOL INJECTION PACKAGE G-2801
PIPING AND INSTRUMENTATION DIAGRAM

BUDGET REF. 11594	DRAWING No.	REV.
PROJECT No. 11594	SCALE N.T.S	1
AD-28-D-100004-SHT-001		