


EQUIPMENT No.	GP-2802
NAME	PIG LAUNCHER
SIZE	(405 X 505) mm OD DIA X 5900 mm L
DESIGN PRESSURE	350.0 barg / VACUUM
DESIGN TEMP.	-46 °C / 125 °C
TRIM NUMBER	

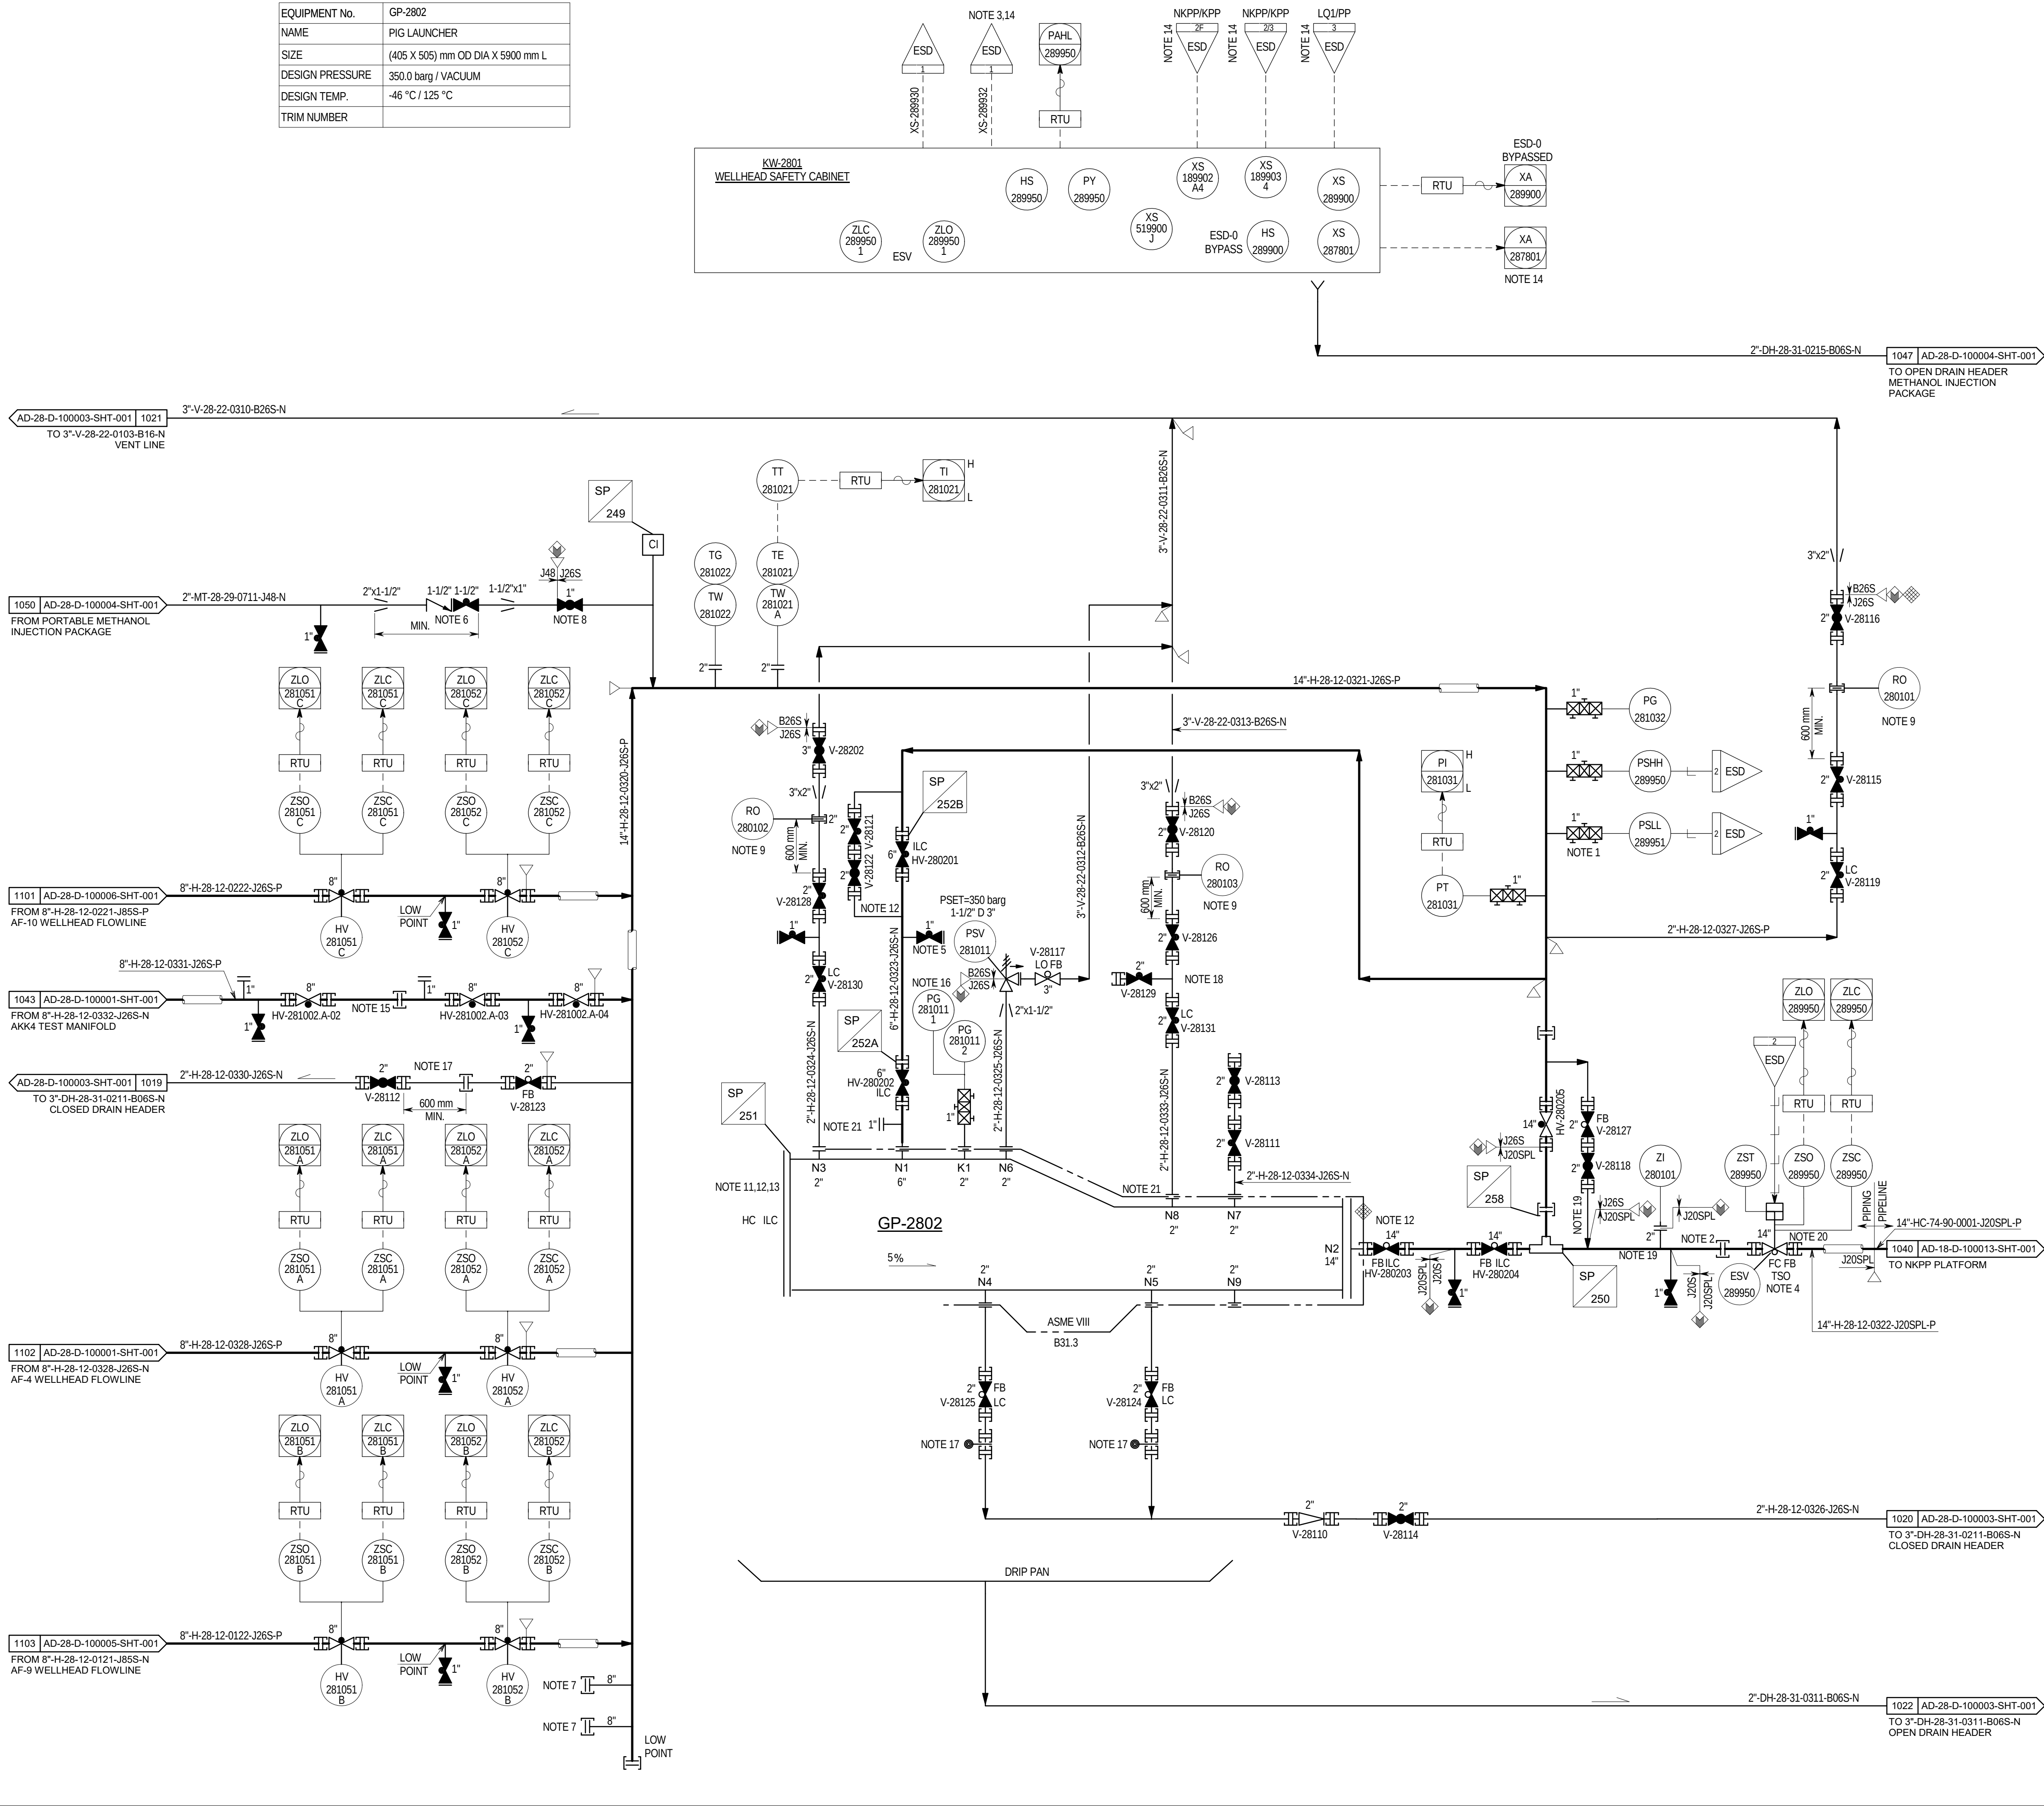

NOTES

1. LOW LOW OR HIGH HIGH PRESSURE CLOSE WING AND MASTER VALVES OF EXISTING AND NEW WELL HEADS.
2. SPOOL PIECE FOR MAINTENANCE PURPOSES.
3. SIGNAL TO NKPP SWITCH BOARD.
4. ESV ON RISER TO BE LOCATED IN SAFE AREA AWAY FROM POTENTIAL FIRE OR EXPLOSION SOURCES. HOWEVER, ACCESS AND MAINTENANCE FACILITIES TO BE PROVIDED.
5. METHANOL AND NITROGEN SUPPLY POINTS TO BE CLOSE TO PIG TRAP. (MAINTENANCE AFTER PIGGING OPERATION).
6. METHANOL INJECTION DEPENDANT ON WELLSTREAM TEMPERATURE AND PRESSURE.
7. CONNECTION FOR FUTURE WELLHEAD.
8. SHUT-IN VALVE (TYPE GLOBE) PART OF VENDOR SUPPLY.
9. TAG NOS. FOR ALL SPADE/RO HUBS SHALL BE:
SP-217A/B FOR PIPE CLASS J85S
SP-218A/B FOR PIPE CLASS J26S
10. NOZZLES ON PIG-LAUNCHER SHALL BE VERTICAL TO THE TRUE HORIZONTAL PLANE.
11. QUICK OPENING CLOSURE DOOR. PROVIDE SPACE FOR PIG HANDLING. DOOR TO BE PROVIDED WITH A MECHANICAL DEVICE TO PROTECT AGAINST OPENING UNDER PRESSURE.
12. THE LAUNCHER SHALL BE PROVIDED WITH KEY INTERLOCK SYSTEM TO PREVENT INADVERTENT OPENING OF LAUNCHER END CLOSURE UNDER PRESSURE.
13. CLOSURE WELD TO BE 100% RADIOGRAPHED.
14. HARD WIRED SIGNALS VIA SUBMARINE CABLE.
15. SPOOL PIECE FOR THREE PHASE FUTURE TEST METER ASSEMBLY TO BE PROVIDED ON VERTICAL LEG.
16. LOW AND HIGH RANGE PRESSURE GAUGE.
17. FOR EACH BLIND SPADE CORRESPONDING SPACER SHOULD ALSO BE PROVIDED.
18. TELL TALE CONNECTION TO BE USED FOR CHECKING H2S LEVEL INSIDE PIG LAUNCHER AFTER N2 PURGING.
19. MINIMUM DISTANCE LARGER THAN THE LENGTH OF INTELLIGENT PIG IS REQUIRED BETWEEN ESV AND PIGGING TEE.
20. ESV 289950 SHALL BE PROVIDED WITH PARTIAL STROKING FACILITY.
21. LOCATE AS CLOSE AS POSSIBLE TO THE ENDS OF PIG LAUNCHER.

LOGIC NOTES

- 1 TO/FROM WELLHEAD SAFETY CABINET.

REFERENCE DRAWINGS

DESCRIPTION	DRAWING NUMBER
P&ID LEGEND, SYMBOLS & INSTRUMENT DETAILS	AD-82-D-100001 TO AD-82-D-100005

SITE WALKTHROUGH DONE ON 15 JAN 2024

THIS DRAWING SUPERSEDES TOTAL ABK DWG. NO. 0000617-28-U-99-108 1/1 REV-4

REV.	DATE	DESCRIPTION	BY	CHK	SD	APPD	APPD
1	18 Jun 2025	AS-BUILT FOR PROJECT NO. 11594 (PACKAGE 6)	SK	MC	TK	GB	SB

CONSULTANT/CONTRACTOR/VENDOR:	
AVENIR INT'L ENGINEERS & CONSULTANTS	P.O. Box. 113917 Abu Dhabi, U.A.E
DRAWING No. :	

PROJECT TITLE: 11594: AS-BUILT RECOVERY - PHASE II (PACKAGE 5: LZ - ZCSC & PACKAGE 6: ABK)



أدنوك البحرية
ADNOC Offshore

DRAWING TITLE:
ABU AL BUKHOOSH WELL HEAD TOWER - AREA 28
AKK 4 WELL HEAD PLATFORM
PIG LAUNCHER AND MANIFOLD
PIPING AND INSTRUMENTATION DIAGRAM

BUDGET REF. 11594	DRAWING No.	REV.
PROJECT No. 11594	SCALE N.T.S	1
AD-28-D-100007-SHT-001		