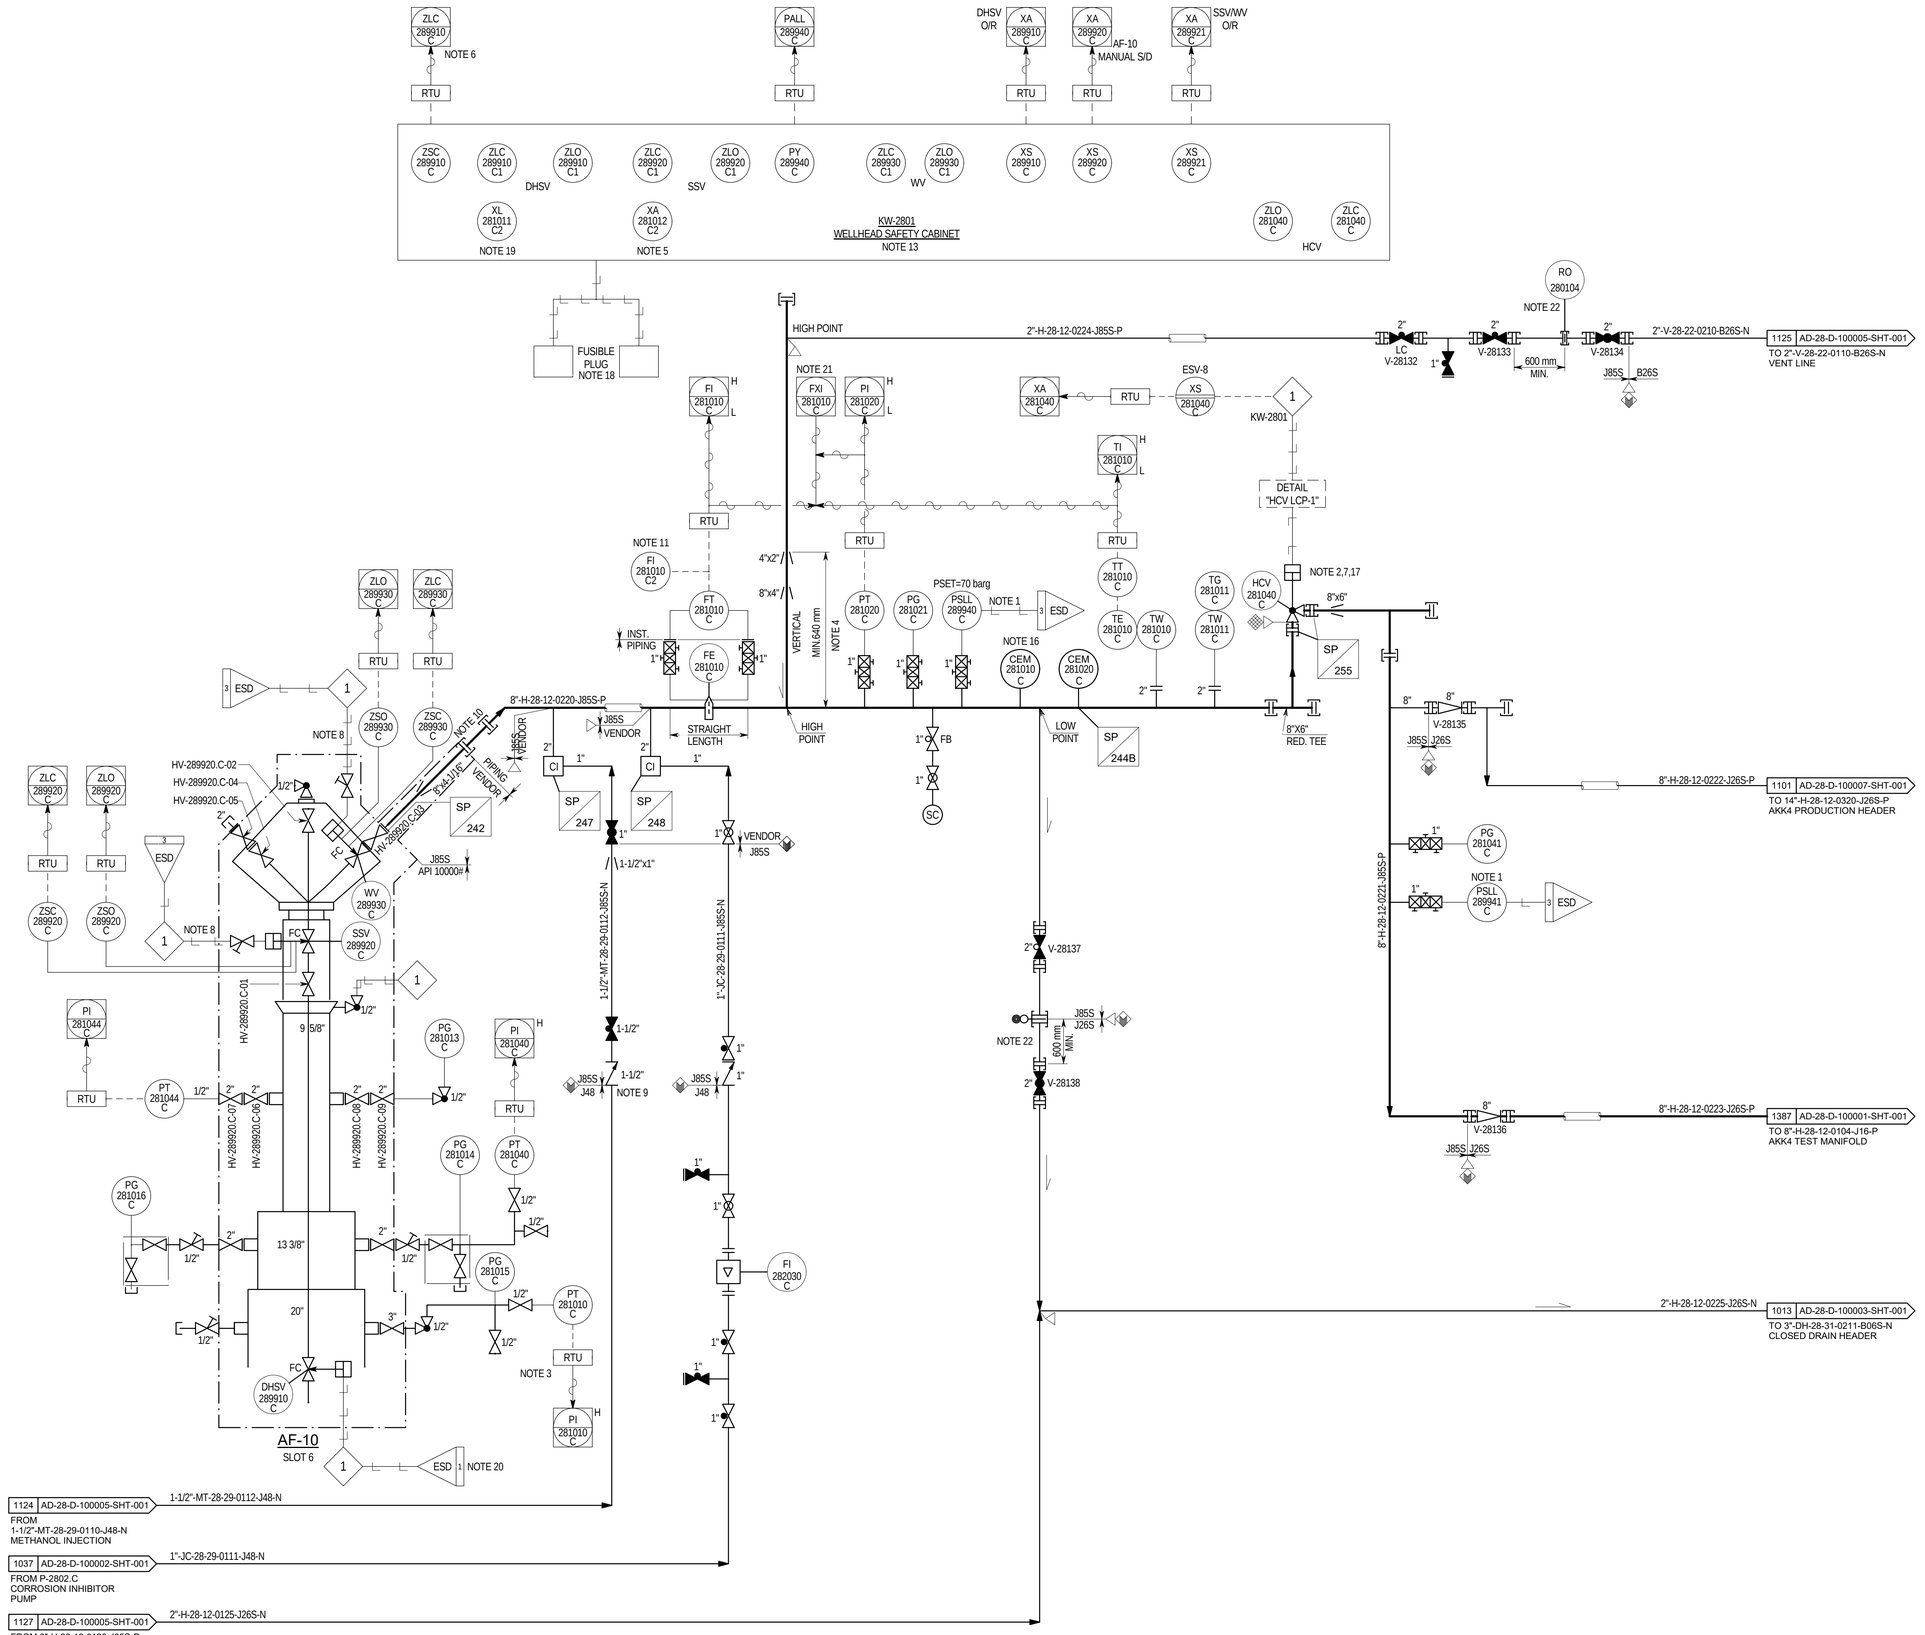

NOTES

1. LOW LOW PRESSURE CLOSES, WING AND MASTER VALVES.
2. IN CASE OF SHUTDOWN, CHOKE VALVE ARE AUTOMATICALLY CLOSE.
3. ANNULUS PRESSURE THROUGH PRODUCTION CASING.
4. DUE TO SPACE LIMITATION ONLY 640MM VERTICAL HEIGHT COULD BE PROVIDED AGAINST MINIMUM 1000MM ENVISAGED IN REV. C2.
5. SIMULTANEOUS OPENING (WITH TIME DELAY) / CLOSURE (WITH WELL ON) OF PRODUCTION / TEST LINES ARE ALARMED ON DCS (XA-281012.C) / WHCP (XA-281012.C2).
6. POSITION STATUS OF DOWNHOLE SAFETY VALVE.
7. PERMISSION TO OPEN THE WELLHEAD VALVES ONLY WHEN CHOKE IS CLOSED.
8. QUICK DUMP VALVES INSTALLED TO REDUCE CLOSURE TIME OF MASTER AND WING VALVE.
9. INJECTION POINT TO BE CLOSE TO WING VALVE.
10. SPOOL PIECE FOR MAINTENANCE PURPOSES.
11. FI - LOCALLY READABLE FROM THE CHOKE VALVE.
12. FOR EACH BLIND SPADE CORRESPONDING SPACER SHOULD ALSO BE PROVIDED.
13. PART OF EXISTING WELLHEAD SAFETY CABINET.
14. CAGED PROTECTION TO BE PROVIDED ON LINE WITH AN OPERATING TEMPERATURE ABOVE 60°C.
15. TAG NOS. FOR ALL SPADE/RO HUBS ARE:
    SP-217A/B FOR PIPE CLASS J85S.
    SP-218A/B FOR PIPE CLASS J26S.
16. CORROSION MONITORING PROBES TO BE INSTALLED IN 9 O'CLOCK POSITION DUE TO PIPING CONSTRAINTS.
17. 8" BREAK OUT HUBS TO BE PROVIDED FOR CHOKE REMOVAL. WHEN WHFP DEPLETES, CHOKE WILL BE REPLACED BY A SPOOL PIECE.
18. EXTEND EXISTING FUSIBLE LINK NETWORK TO COVER NEW WELLS.
19. POSITION INDICATORS ON WHCP (XL-281011.C2) & DCS (XL-281011.C) INDICATE WHICH WELL IS ON TEST.
20. CLOSURE OF DHSV WILL FIRST RESULT IN CLOSURE OF MASTER VALVE (SSV).
21. CORRECTED GAS FLOW CALCULATED IN PLC.

LOGIC NOTES

1 — TO/FROM WELLHEAD SAFETY CABINET.

REFERENCE DRAWINGS

DESCRIPTION	DRAWING NUMBER
P&ID LEGEND, SYMBOLS & INSTRUMENT DETAILS	AD-82-D-100001 TO AD-82-D-100005

SITE WALKTHROUGH DONE ON 15 JAN 2024

THIS DRAWING SUPERSEDES TOTAL ABK DWG. NO. 0000617-28-U-99-107 1/1 REV-5

REV.	DATE	DESCRIPTION	BY	CHK	SD	APPD	APPD
1	18 Jun 2025	AS-BUILT FOR PROJECT NO. 11594 (PACKAGE 6)	VC	MC	TK	GB	SB

~~CONSULTANT~~/CONTRACTOR/~~VENDOR~~:

AVENIR INT'L ENGINEERS & CONSULTANTS
P.O. Box. 113917
Abu Dhabi, U.A.E

DRAWING No. :

PROJECT TITLE:
11594: AS-BUILT RECOVERY - PHASE II
(PACKAGE 5: LZ - ZCSC & PACKAGE 6: ABK)

أدنـوك البحرية
ADNOC Offshore

DRAWING TITLE:
ABU AL BUKHOOSH WELL HEAD TOWER - AREA 28
AKK 4 WELL HEAD PLATFORM
AF-10 AKK4 WELLHEAD FLOW LINES
PIPING AND INSTRUMENTATION DIAGRAM

BUDGET REF.	DRAWING No.	REV.
11594	AD-28-D-100006-SHT-001	1
PROJECT No. 11594 / SCALE N.T.S		

SHT. SIZE: A1

THE INFORMATION/DESIGN CONTAINED ON THIS DRAWING IS CONFIDENTIAL. IT MUST NOT BE COPIED, GIVEN AWAY, LENT OR MADE AVAILABLE TO A THIRD PARTY WITHOUT THE WRITTEN CONSENT OF ADNOC Offshore.
ALL THE WORK TO BE CARRIED OUT IN ACCORDANCE WITH THE CONTRACT SPECIFICATION. EXPLANATIONS OF ABBREVIATIONS, SYMBOLS ETC. ARE GIVEN IN ADNOC Offshore CODES OF PRACTICE.

FILE NAME: AD-28-D-100006-SHT-001.pid